


Crooks Hollow Road, Greensville Ontario

**Hamilton**  
Building Division


Reviewed for Ontario Building Code Compliance.  
Subject to Corrections Noted on Plans and Field Inspections.

Permit: 21 104263 000 00 DP  
Date: 02/04/21  
Name: Mike Dent  
Approved: *Mike Dent*

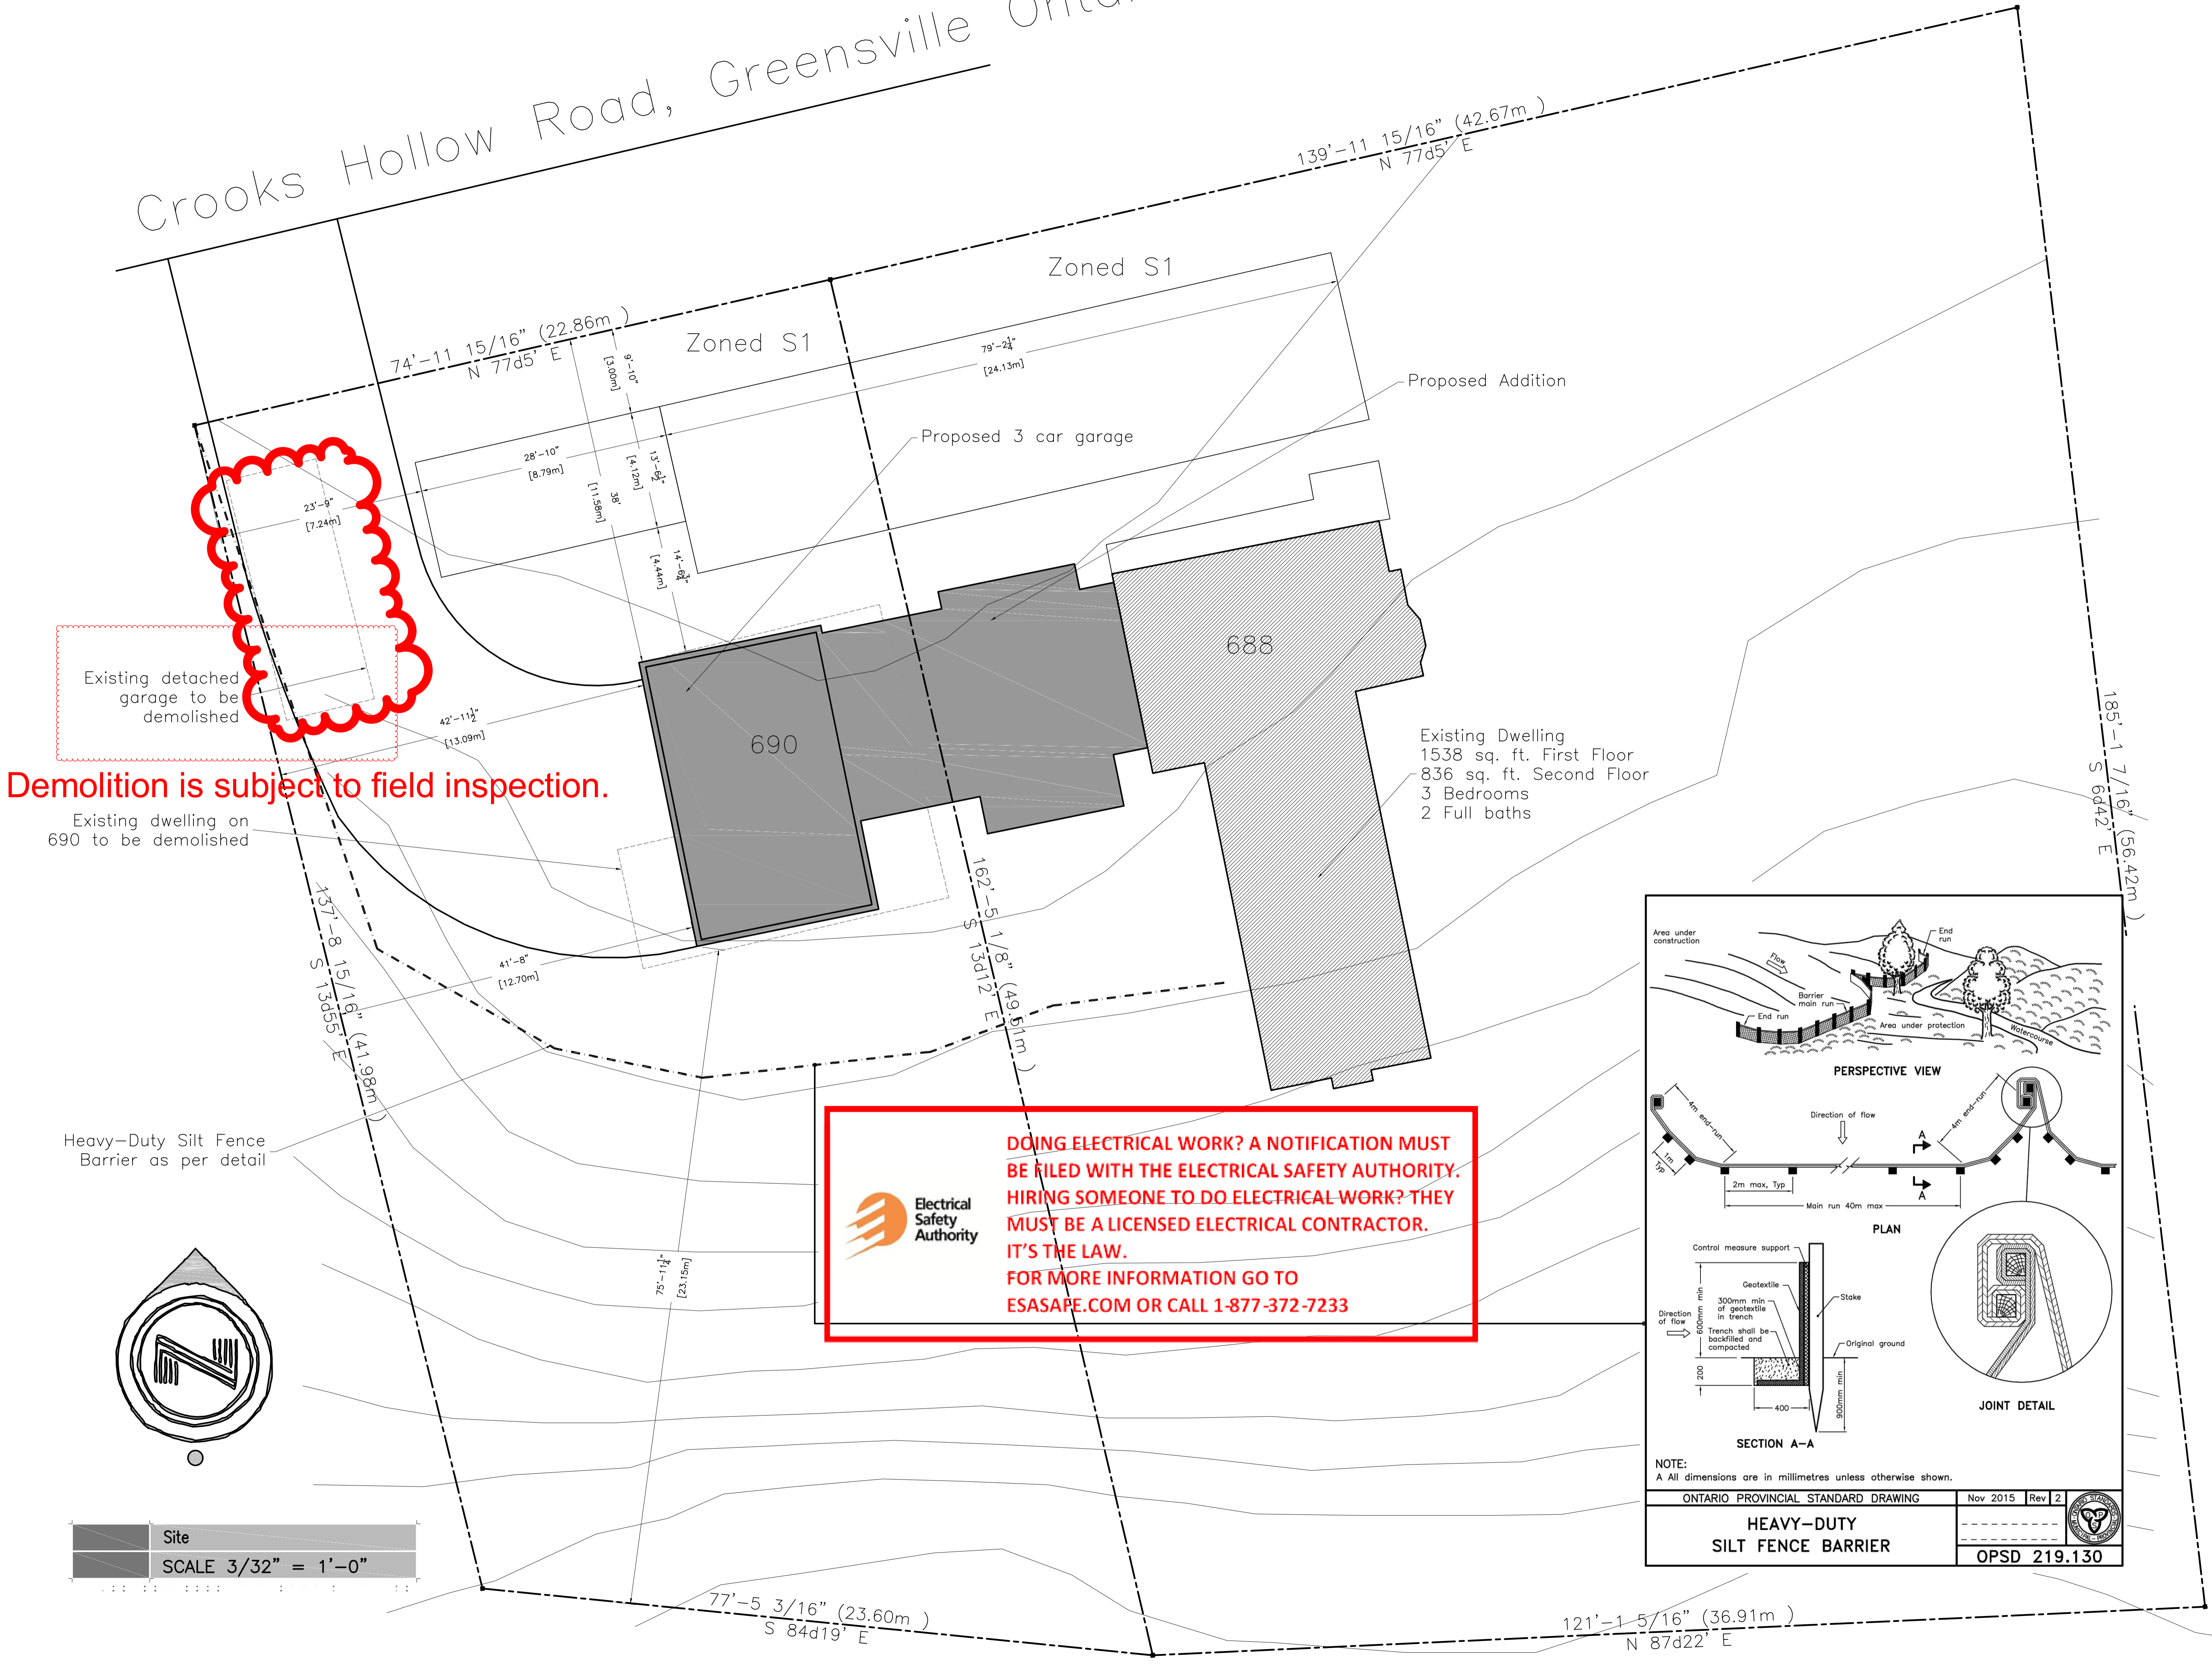

**Electrical Safety Authority**

**DOING ELECTRICAL WORK? A NOTIFICATION MUST BE FILED WITH THE ELECTRICAL SAFETY AUTHORITY. HIRING SOMEONE TO DO ELECTRICAL WORK? THEY MUST BE A LICENSED ELECTRICAL CONTRACTOR. IT'S THE LAW. FOR MORE INFORMATION GO TO ESASAFE.COM OR CALL 1-877-372-7233**

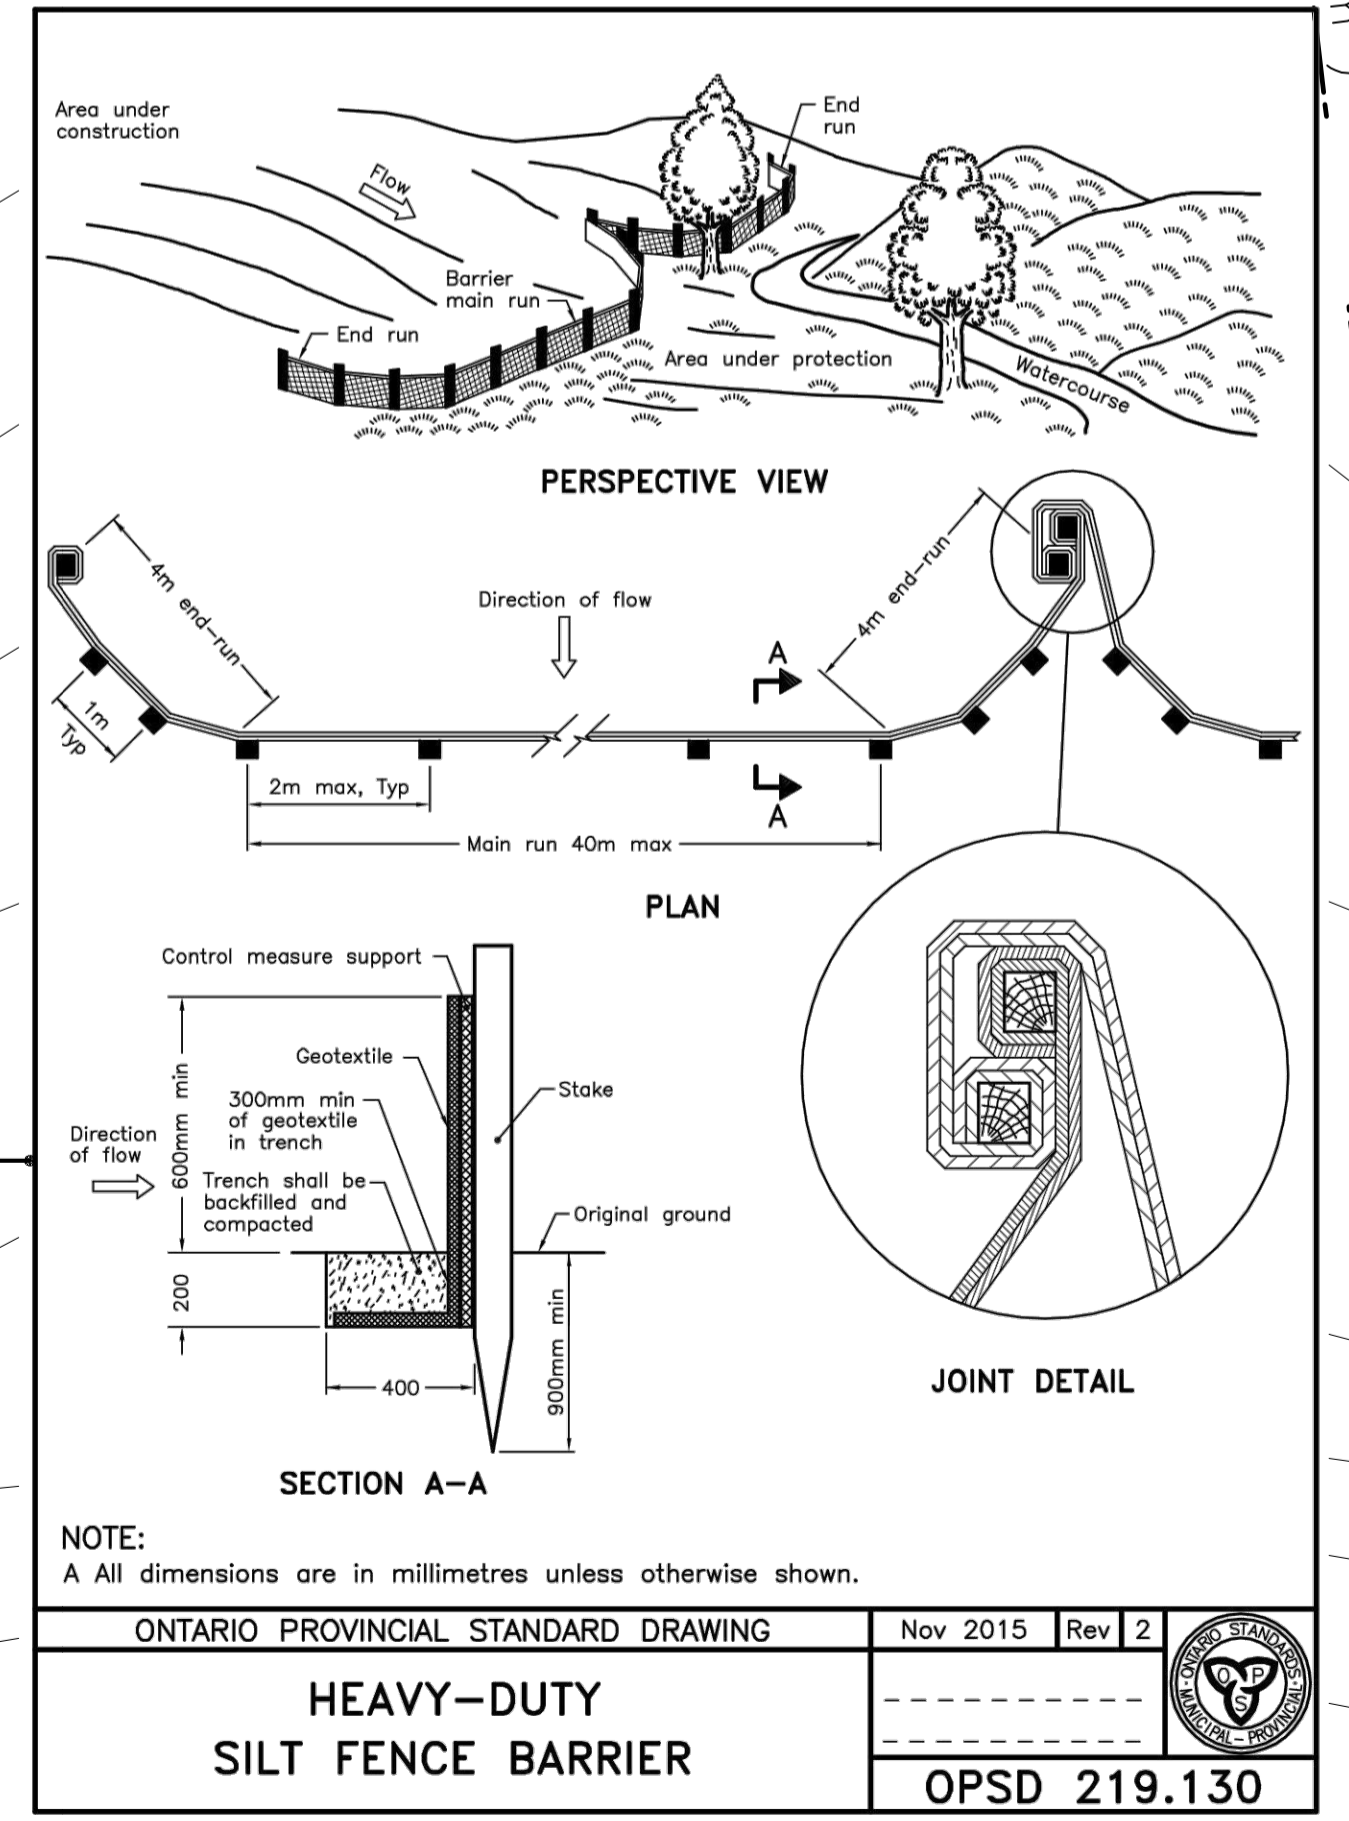

Site  
SCALE 3/32" = 1'-0"

**VIRTUAL CREATIONS INC.** PROJECT: 690 Crooks Hollow Road, Dundas Ontario  
Client: Mr. & Mrs. Shrien  
Classification: **SMALL BUILDINGS**  
Original Signature: *ELL*  
**WWW.VCINC.CA**

PROJECT NO: 2020-002  
BCIN No. **28844**  
ERIC CANTON BCIN#25135  
(905) 481 1153

AT VIRTUAL CREATIONS INC. THE BEST EFFORT HAS BEEN MADE TO RECORD EXISTING BUILDING STRUCTURES AND PROPOSED A COMPREHENSIVE SET OF CONSTRUCTION DRAWINGS. HOWEVER, THERE ARE AREAS AT THE TIME OF DESIGNING THAT ARE UNAVAILABLE OR INACCESSIBLE. WITH PROPER CO-ORDINATION TO THE CLIENT, THE DESIGNER WILL ATTEMPT TO OBTAIN THE NECESSARY INFORMATION TO COMPLETE THE DRAWINGS. THE CLIENT IS ADVISED THAT THE DRAWINGS ARE FOR INFORMATION ONLY AND ARE NOT TO BE USED FOR CONSTRUCTION. ALL DESIGNS AND DRAWINGS ARE THE SOLE PROPERTY AND COPYRIGHT OF VIRTUAL CREATIONS INC. ANY REPRODUCTIONS MUST BE AUTHORIZED BY VIRTUAL CREATIONS INC. OR PURCHASED THROUGH VIRTUAL CREATIONS INC. DIRECTLY.

ISSUED: Jan 20 2021

SP1-0