


Name: Sam Brush
 Title: Urban Forest Health Tech
 Phone Number: 905-546-2424 ext. 7375

APPROVED
 By Sam Brush at 11:19 am, Apr 21, 2021

Plan is inaccurate as it relates to the location of the 9cm Downy Serviceberry in good condition. Tree is 11m (36 feet) from the property line. Forestry approves this plan as the tree protection zone of 1.5m is easily obtainable.

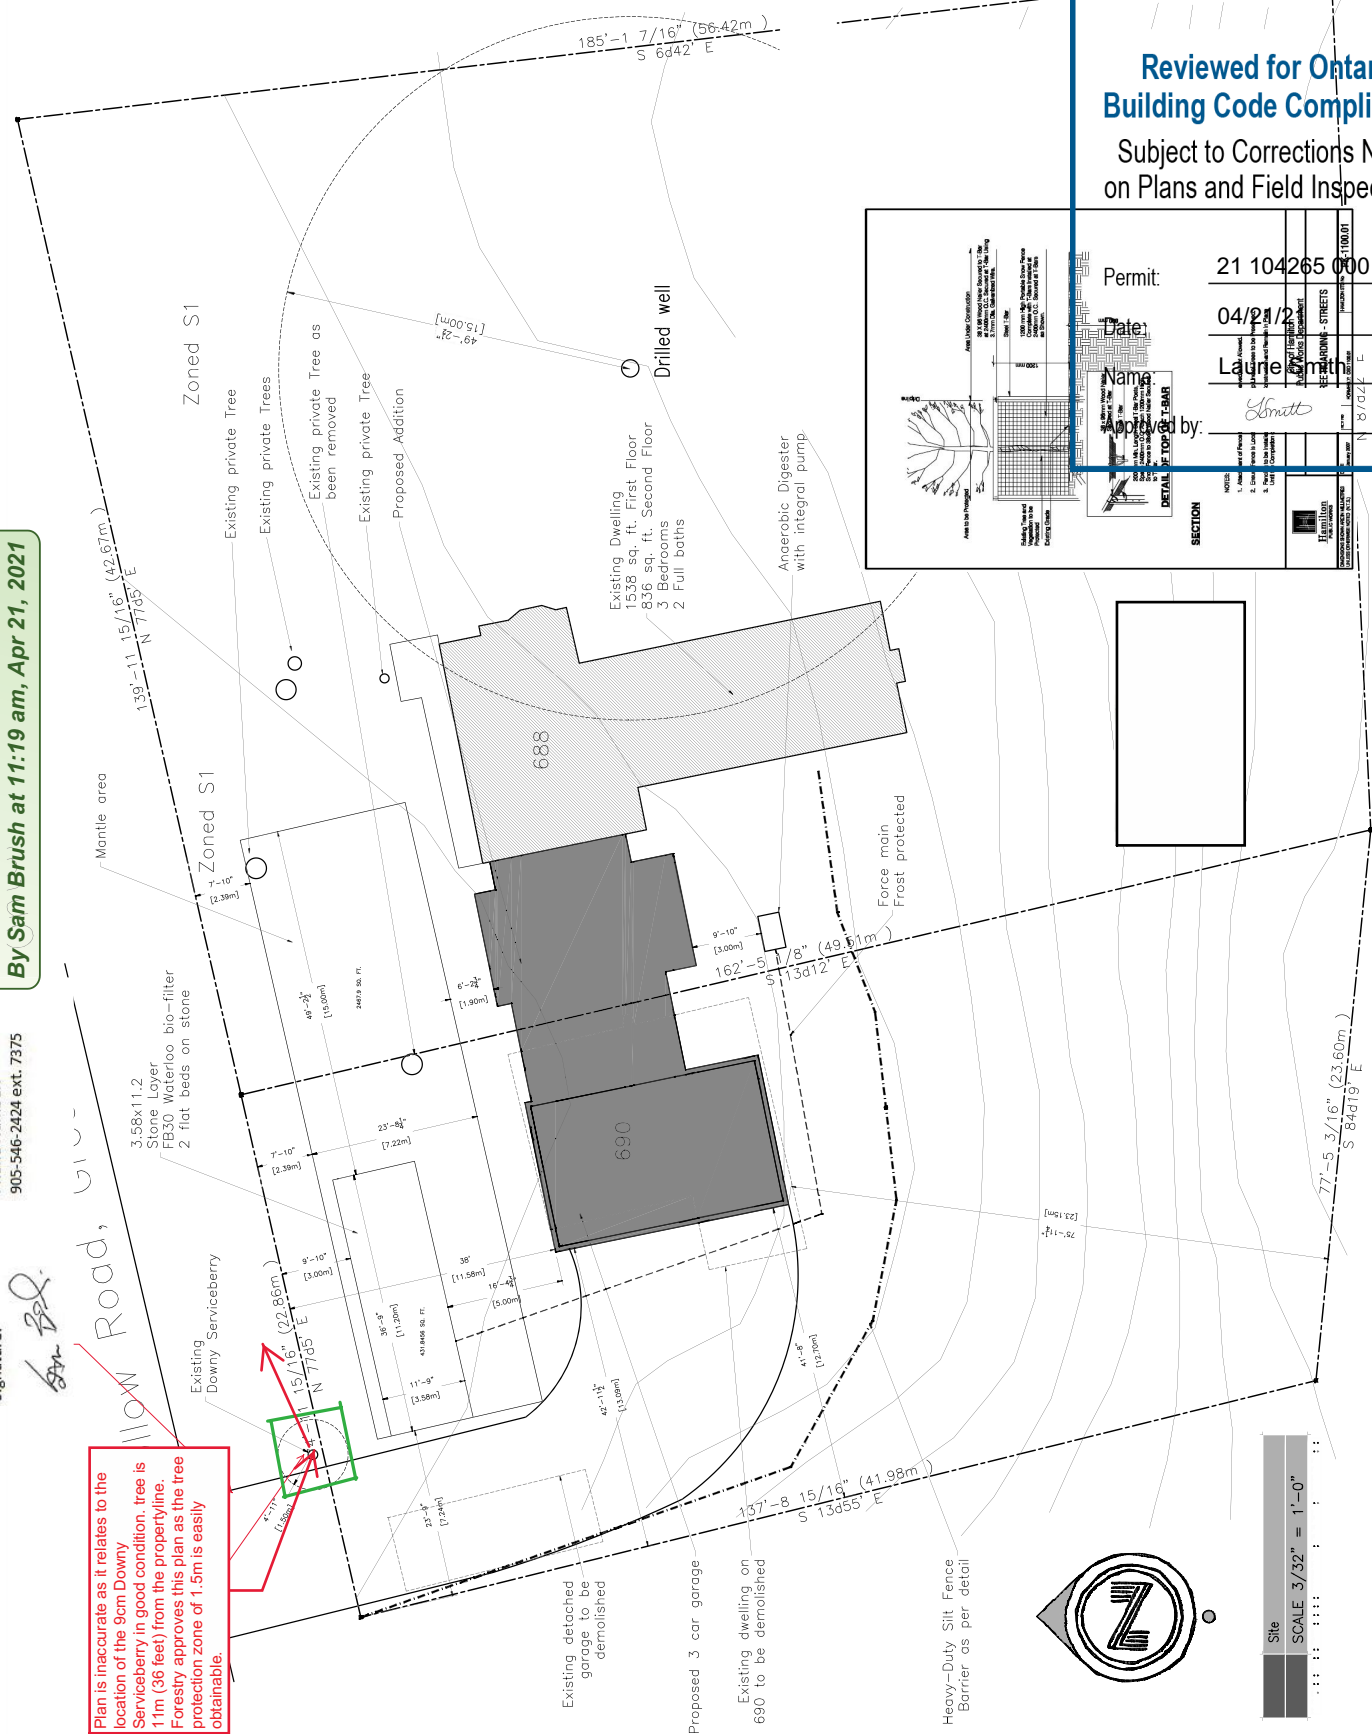

Site SCALE 3/32" = 1'-0"

Permit	21 104265 000 00 DP
Date	04/21/21
Name	Laurie Smith
Approved by:	<i>Smith</i>

Reviewed for Ontario Building Code Compliance.
 Subject to Corrections Noted on Plans and Field Inspections.

