
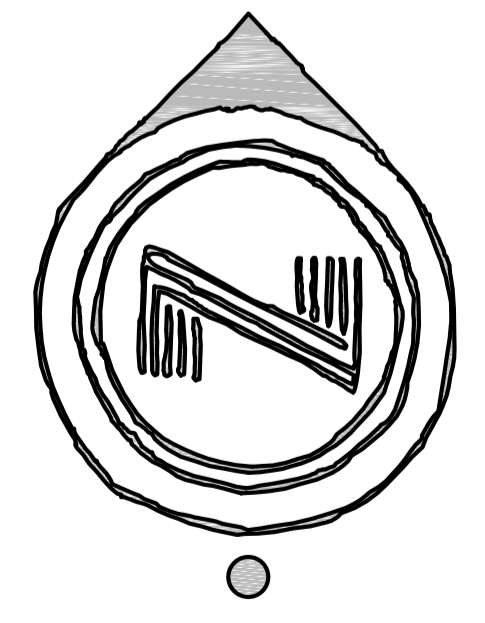


Crooks Hollow Road, Greensville Ontario


Hamilton
Building Division

Reviewed for Ontario Building Code Compliance.
Subject to Corrections Noted on Plans and Field Inspections.

Permit: 21 104265 000 00 DP
Date: 04/21/21
Name: Laurie Smith

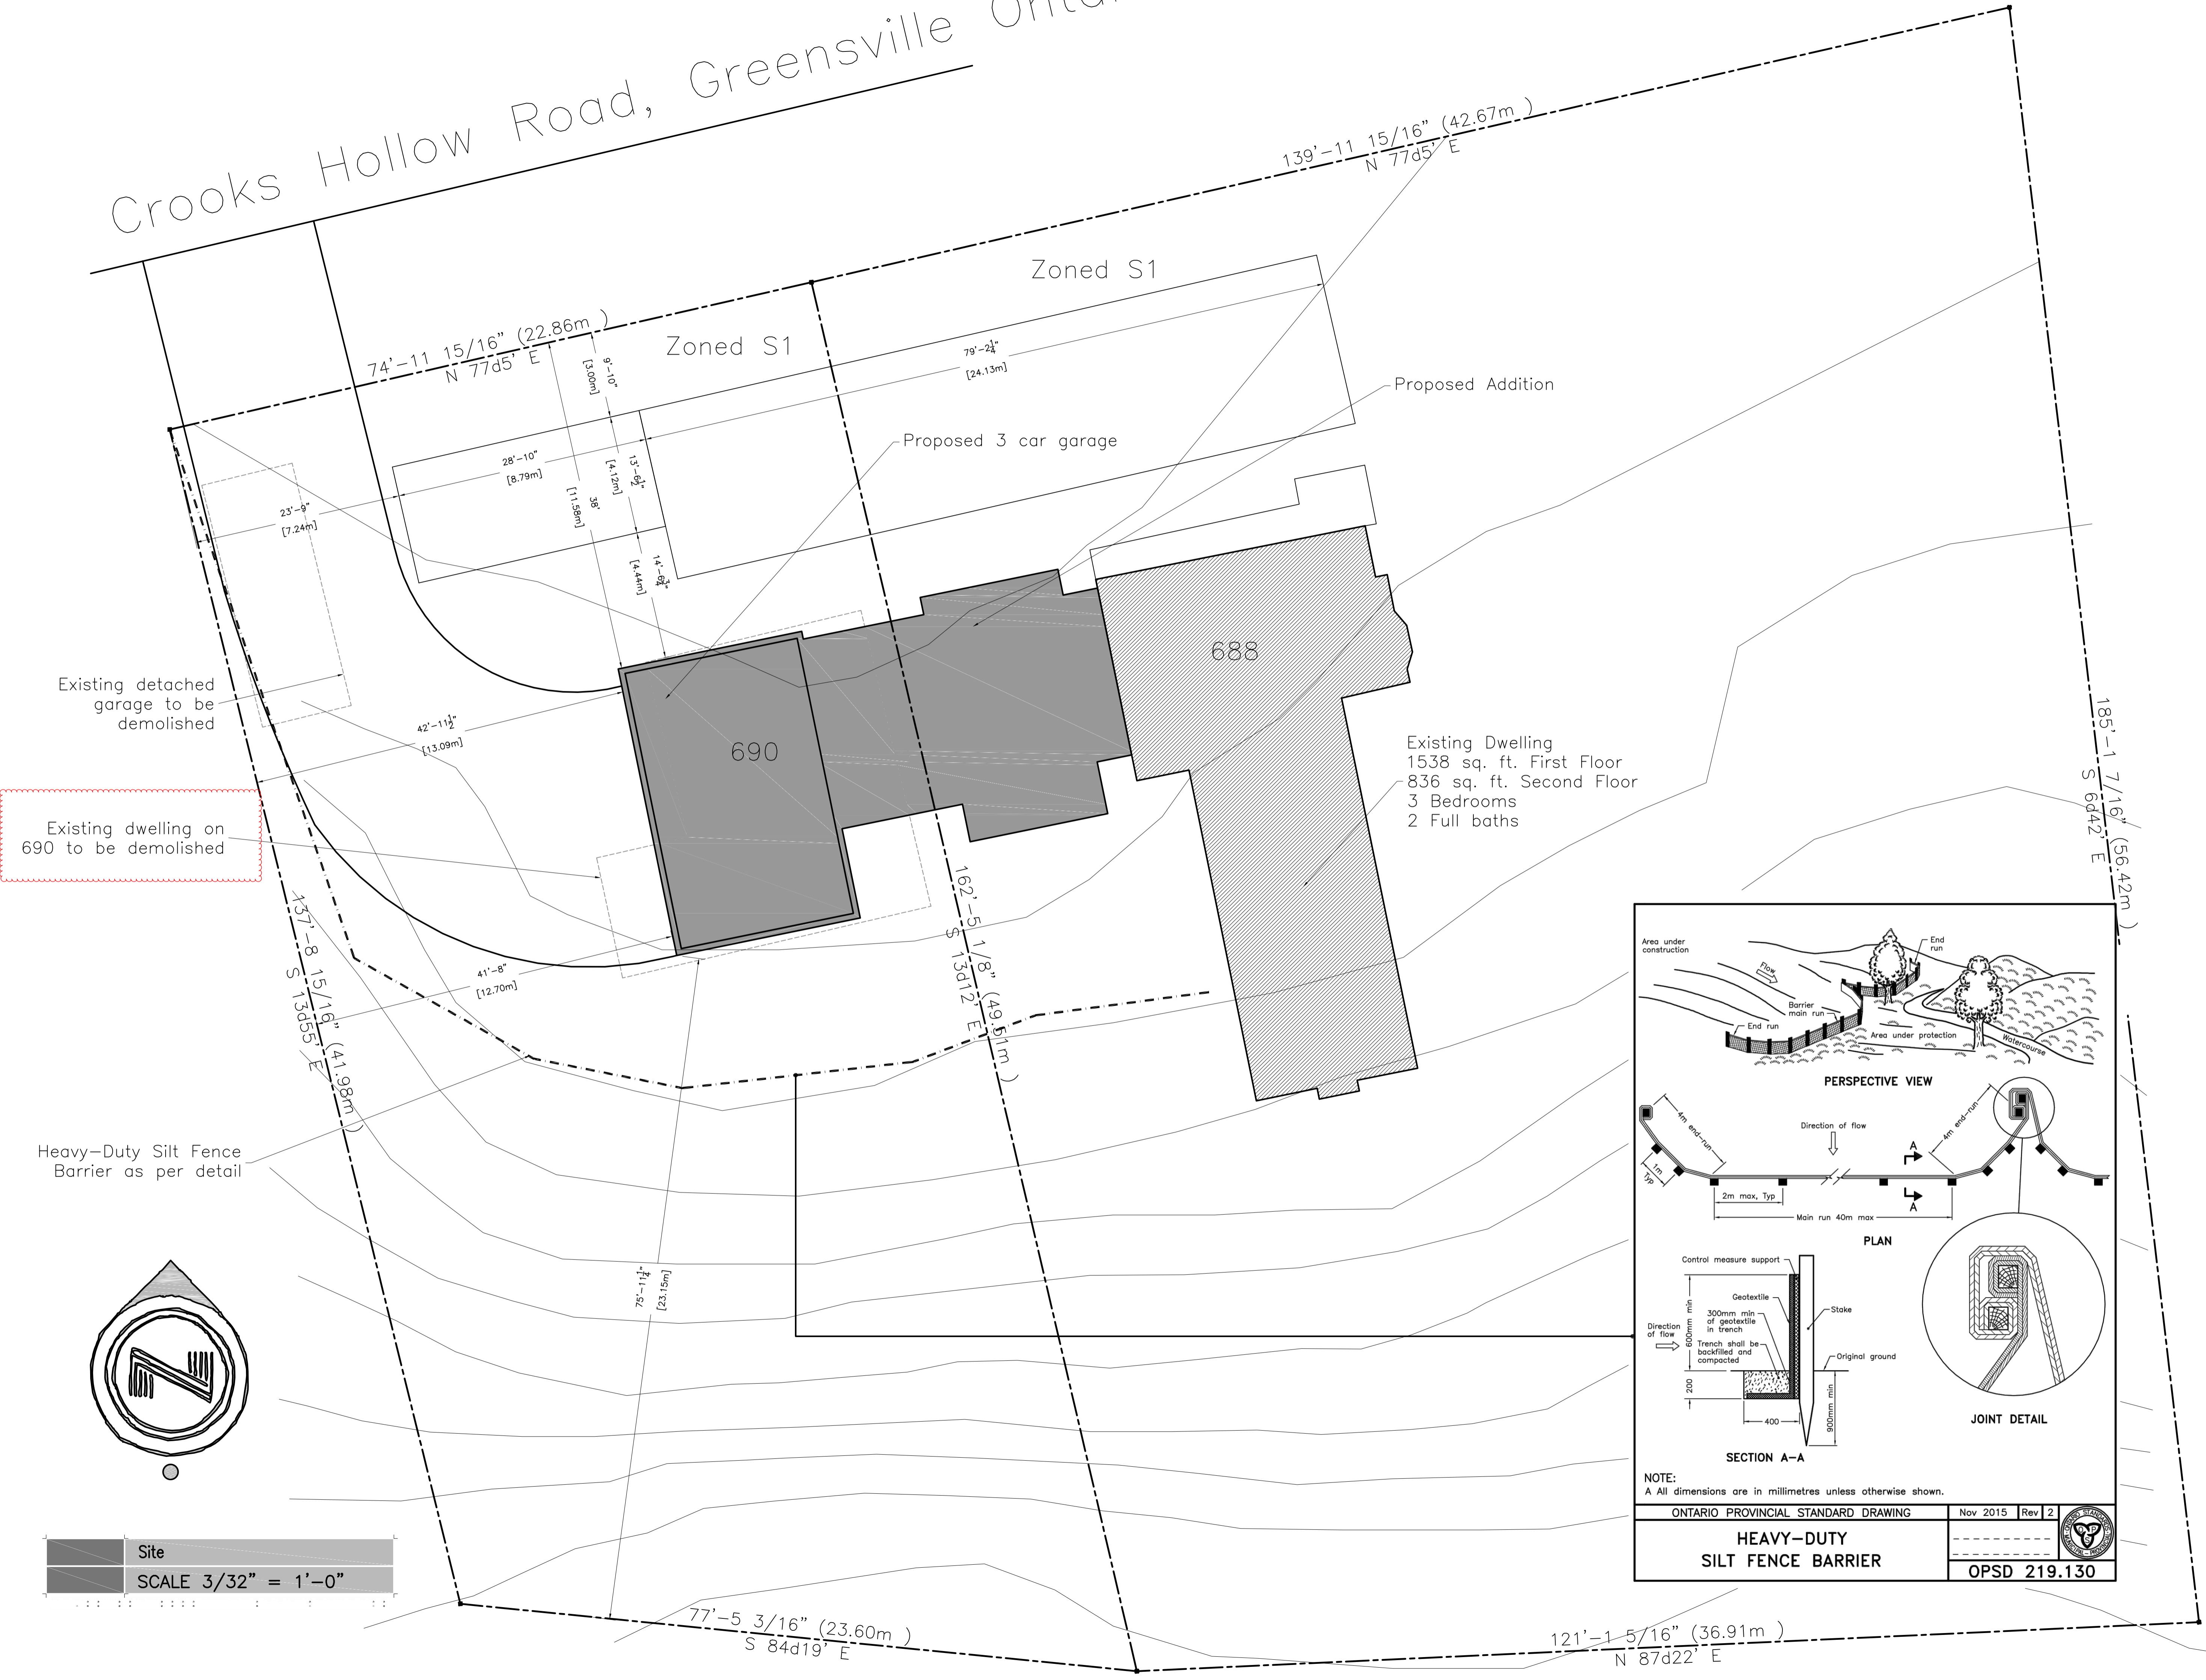

Site
SCALE 3/32" = 1'-0"

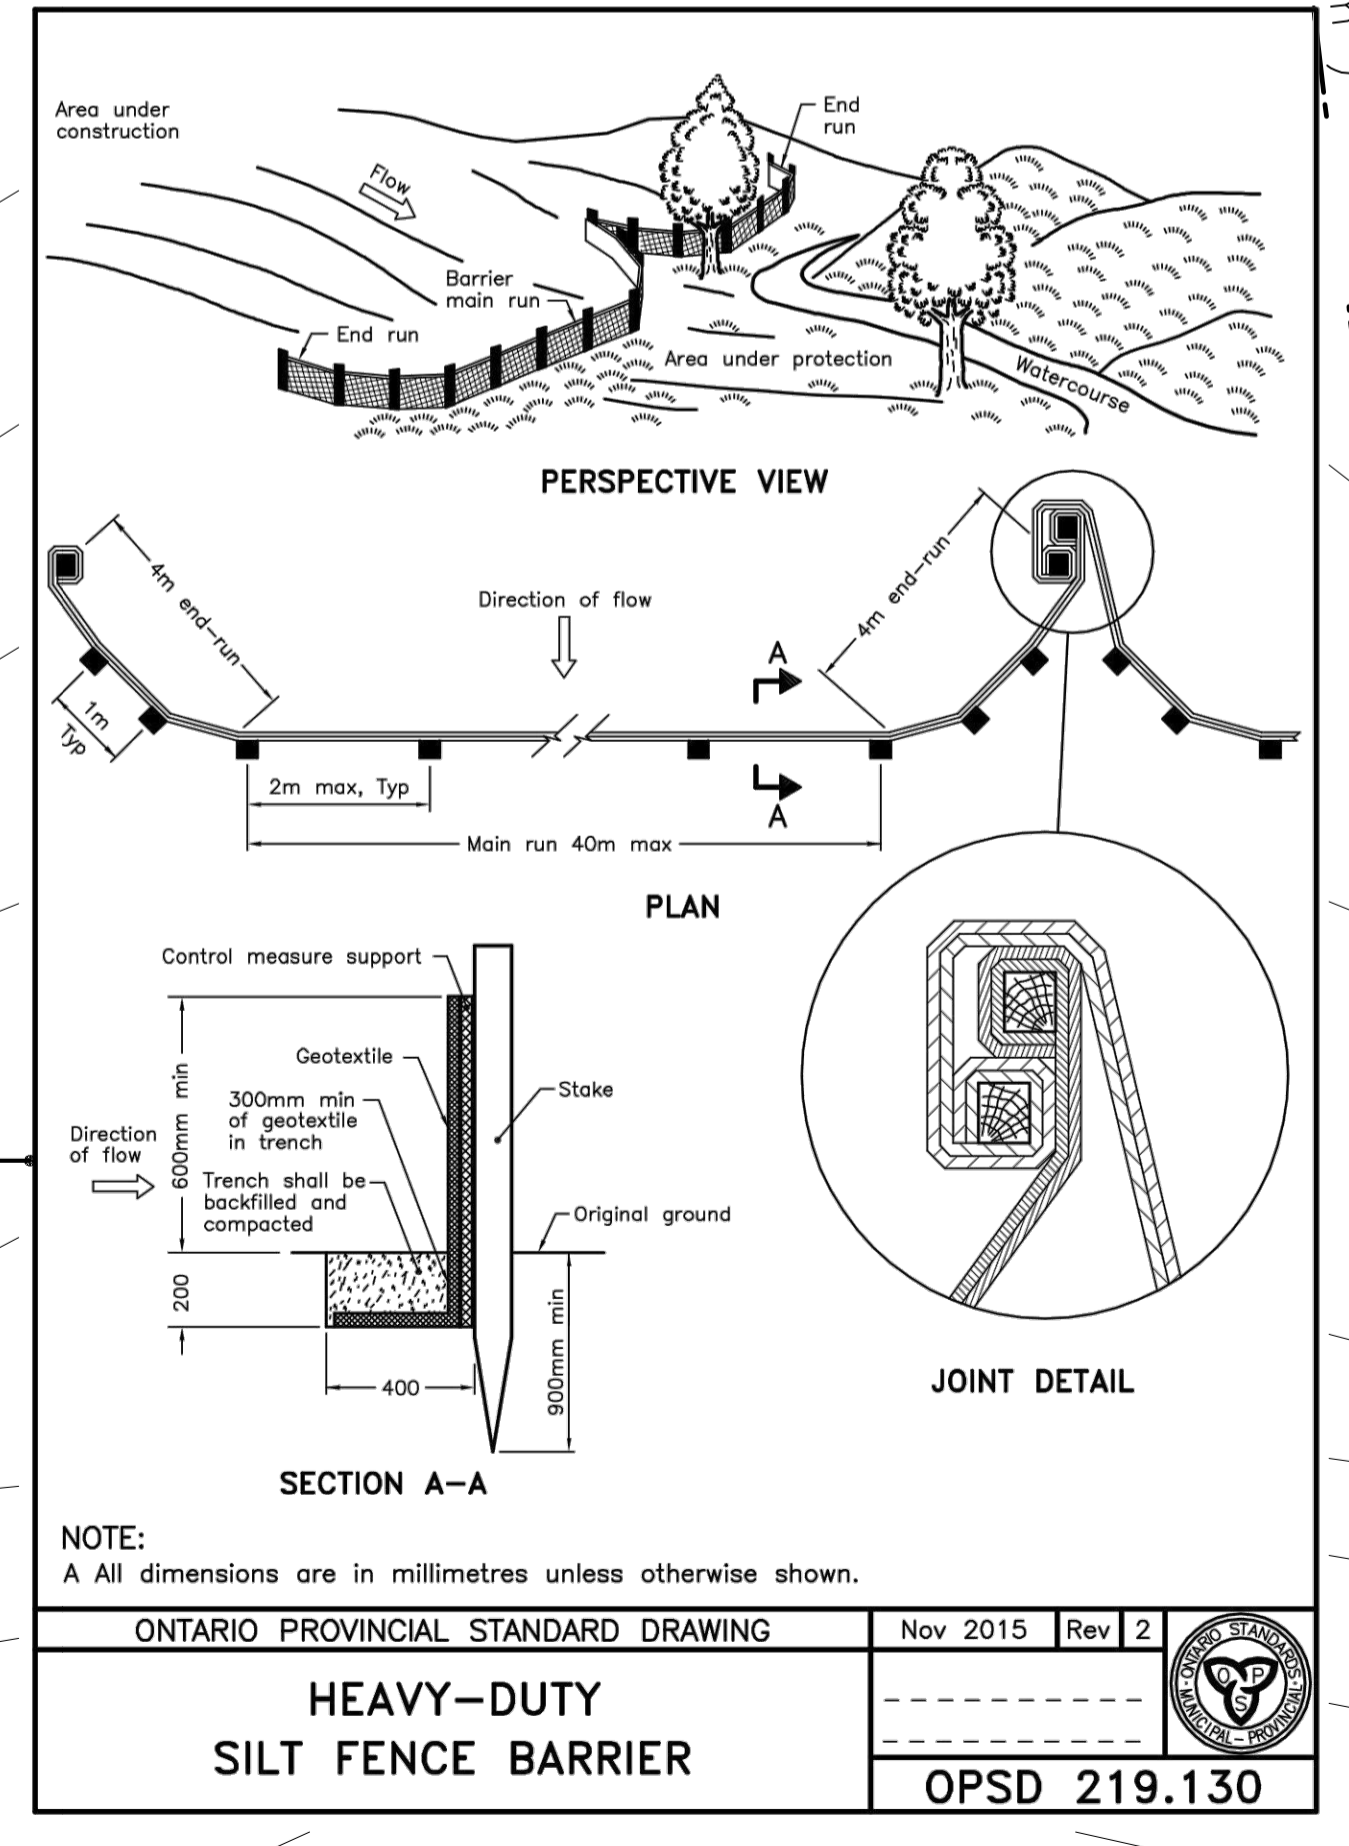

VIRTUAL CREATIONS INC.
(905) 481-1153 BCIN No. 28844
ERIC CANTON BCIN#25135

PROJECT: 690 Crooks Hollow Road, Dundas Ontario
Client: Mr. & Mrs. Shrien
Classification: **SMALL BUILDINGS**
Original Signature: *ELT*
WWW.VCINC.CA

AT VIRTUAL CREATIONS INC. THE BEST EFFORT HAS BEEN MADE TO RECORD EXISTING BUILDING STRUCTURES AND PROPOSED A COMPREHENSIVE SET OF CONSTRUCTION DRAWINGS. HOWEVER, THERE ARE AREAS AT THE TIME OF DESIGNING THAT ARE UNAVAILABLE OR INACCESSIBLE. WITH PROPER CO-ORDINATION TO THE CLIENT, THE DESIGNER WILL ATTEMPT TO DETERMINE THE EXISTING LOCATIONS OF EXISTING SERVICES. INFORM VIRTUAL CREATIONS INC. OF ANY CHANGES, DISCREPANCIES OR SUBSTITUTIONS FOR REVIEW BEFORE COMMENCING CONSTRUCTION. ALL DESIGNS AND DRAWINGS ARE THE SOLE PROPERTY AND COPYRIGHT OF VIRTUAL CREATIONS INC. ANY REPRODUCTIONS MUST BE AUTHORIZED BY VIRTUAL CREATIONS INC. OR PURCHASED THROUGH VIRTUAL CREATIONS INC. DIRECTLY.

ISSUED: Jan 20 2021

SP1-0