
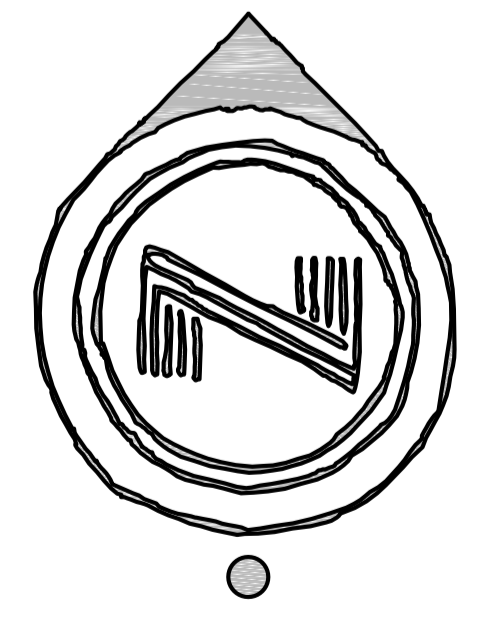


Crooks Hollow Road, Greenville Ontario

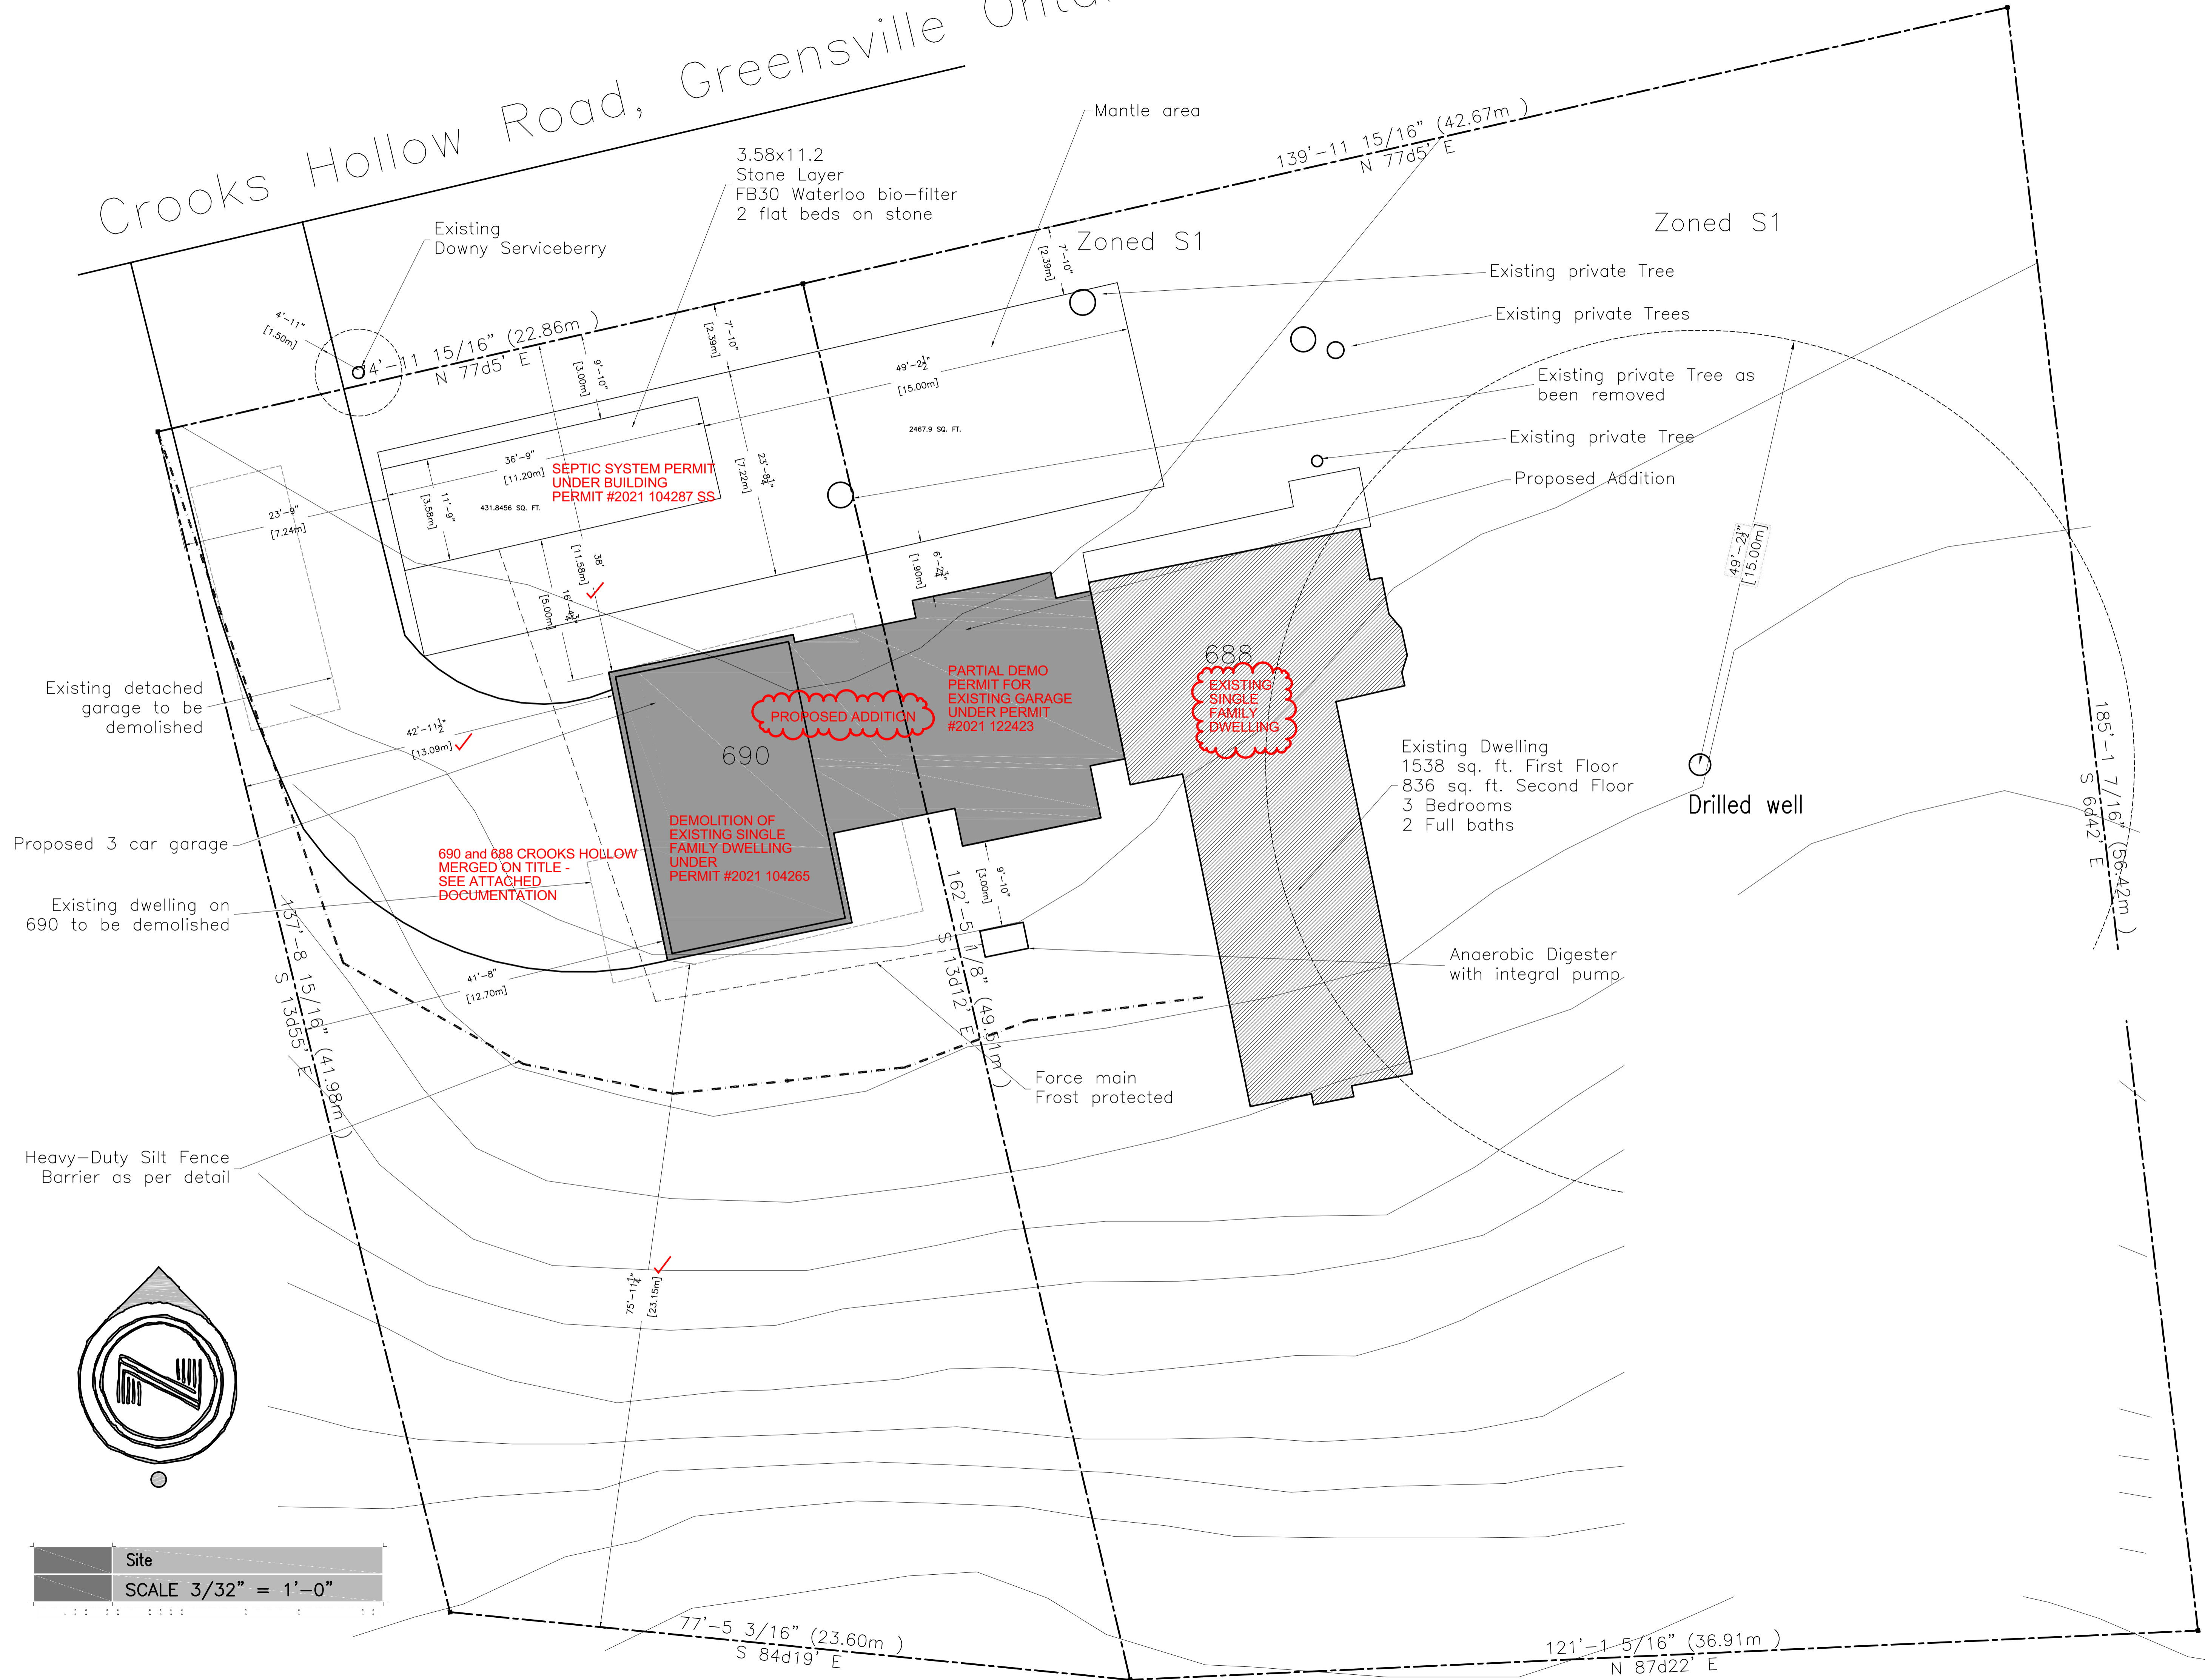

Site
SCALE 3/32" = 1'-0"

Hamilton Building Division

Reviewed for Ontario Building Code Compliance. Subject to Corrections Noted on Plans and Field Inspections.

Permit: 21 104272 000 00 R9
Date: 05/19/21
Name: Laurie Smith

PROJECT: 690 Crooks Hollow Road, Dundas Ontario
 CLASSIFICATION: **SMALL BUILDINGS**
 ORIGINAL SIGNATURE: *ELT*
 WWW.VCINC.CA
 Mr. & Mrs. Shrien
 Client: **28844**
 BCIN No. **28844**
 ERIC CANTON BCIN#25135

AT VIRTUAL CREATIONS INC. THE BEST EFFORT HAS BEEN MADE TO RECORD EXISTING BUILDING STRUCTURES AND PROPOSED A COMPREHENSIVE SET OF CONSTRUCTION DRAWINGS. HOWEVER, THERE ARE AREAS AT THE TIME OF DESIGNING THAT ARE UNAVAILABLE OR INACCESSIBLE. WITH PROPER COORDINATION WITH THE CLIENT, THESE AREAS WILL BE IDENTIFIED AND THE DRAWINGS WILL BE REVISED TO REFLECT THE ACTUAL CONDITIONS. VIRTUAL CREATIONS INC. IS NOT RESPONSIBLE FOR ANY CHANGES, DISCREPANCIES OR SUBSTITUTIONS FOR REVIEW BEFORE COMMENCING CONSTRUCTION. ALL DESIGNS AND DRAWINGS ARE THE SOLE PROPERTY AND COPYRIGHT OF VIRTUAL CREATIONS INC. ANY REPRODUCTIONS MUST BE AUTHORIZED BY VIRTUAL CREATIONS INC OR PURCHASED THROUGH VIRTUAL CREATIONS INC DIRECTLY.

ISSUED: Apr 13 2021