


Cross Hollow Road, Greensville Uninc.


Note: Proposed driveway shall not be less than 1.5m of existing free asset.

Approximately 5cm Downy Serviceberry in site. Minimum tree protection required is 1.5m from stem and not to be excavated.

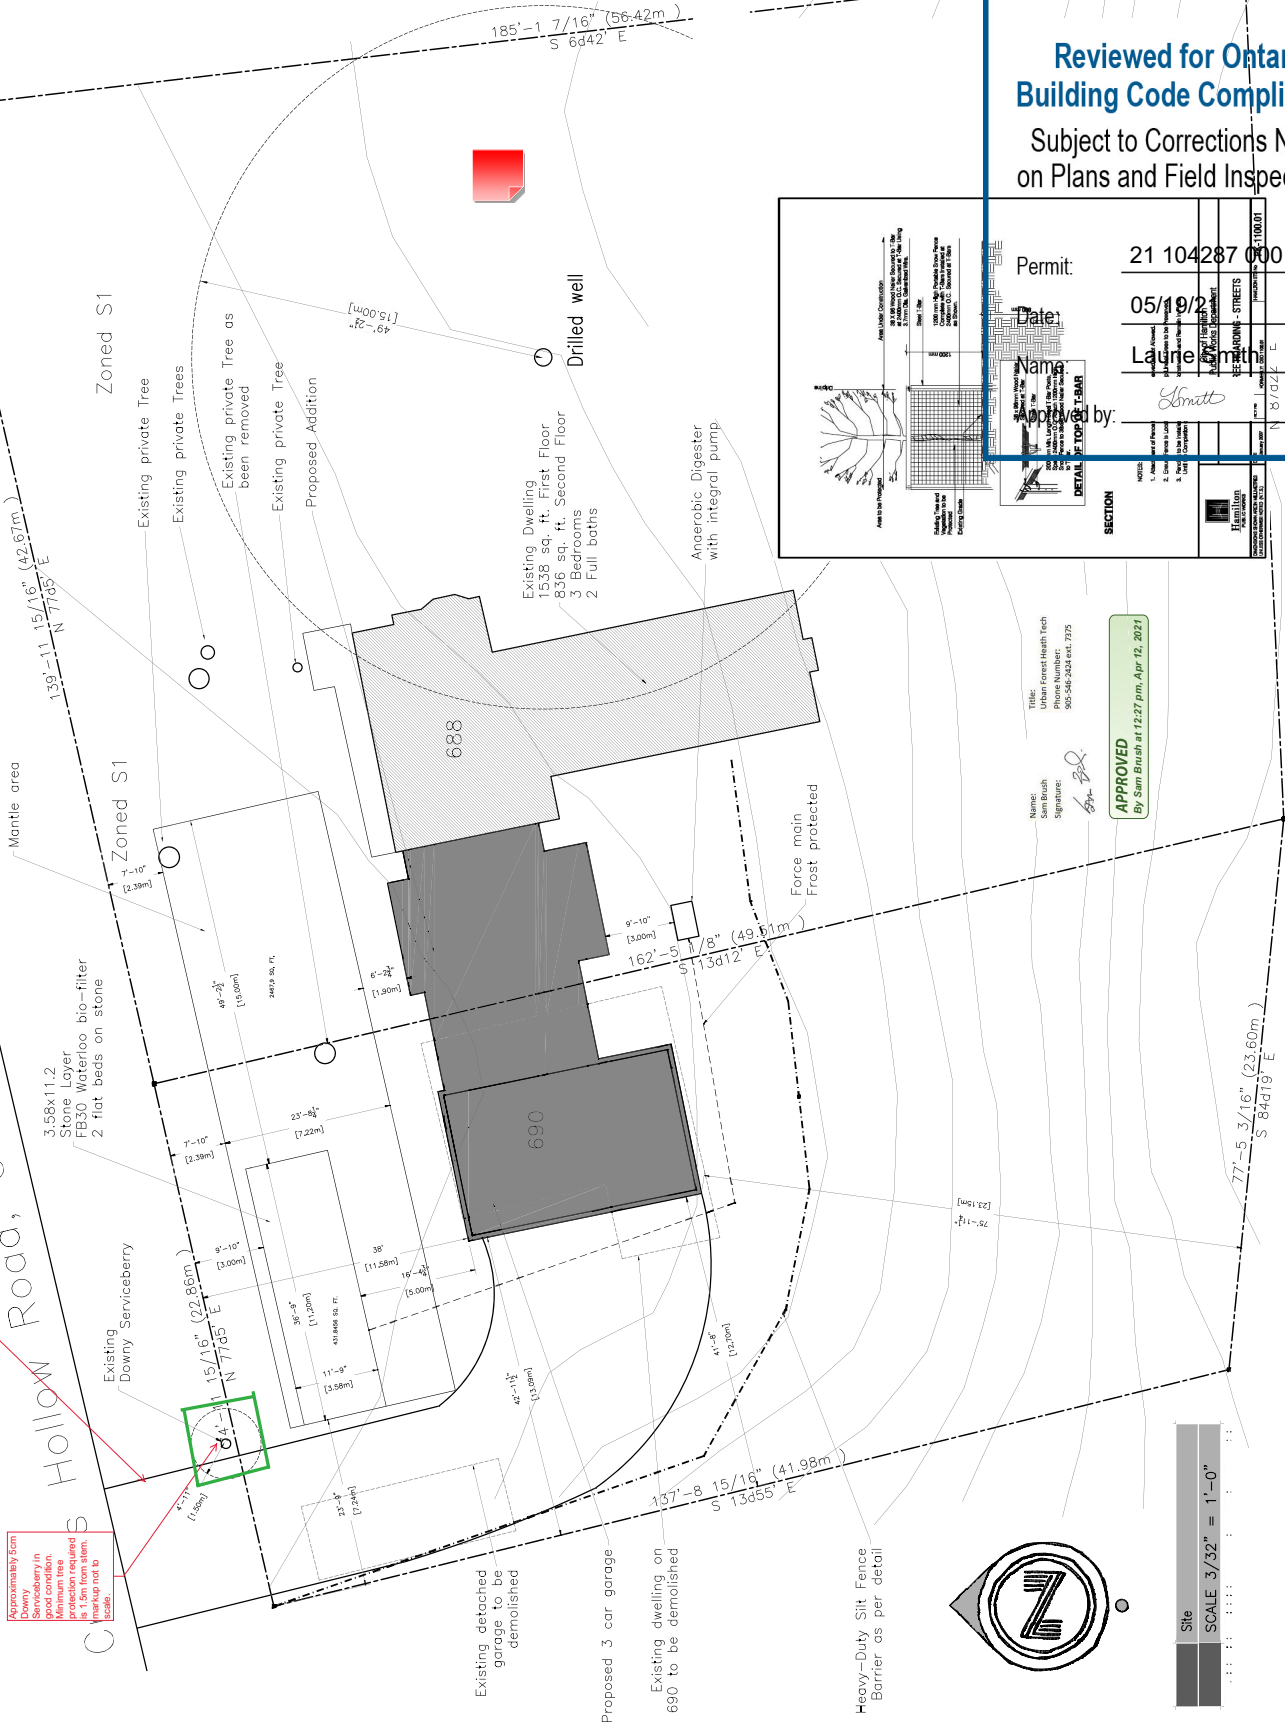


Reviewed for Ontario Building Code Compliance.
Subject to Corrections Noted on Plans and Field Inspections.

Permit: 21 104287 000 00 SS
Date: 05/19/2021
Name: *Laurel Smith*
Approved by: *Laurel Smith*

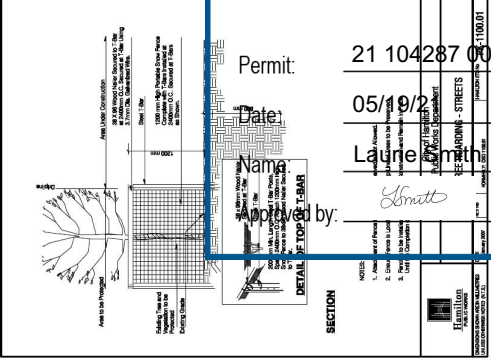

Name: Sam Bush
Title: Urban Forest Health Tech
Signature: *Sam Bush*
APPROVED
By Sam Bush at 12:27 pm, Apr 12, 2021

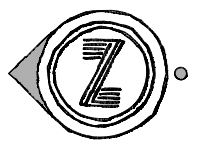

Site SCALE 3/32" = 1'-0"