

2 ON STAIRS  
 FLOOR  
 FLAT HEADS  
 8m x 5m  
 DOUBLE LAYER

Crooks Hollow Road, Greenville Ontario

AS PER DEMO PERMIT  
 #2021 104263

Existing detached garage to be demolished  
 Existing dwelling on 690 to be demolished



Heavy-Duty Silt Fence Barrier as per detail



Site  
 SCALE 3/32" = 1'-0"

FOR DEMO  
 FIRST PROTECTED.

AVAILABLE DUES TABLE  
 WITH EXISTING PLANS

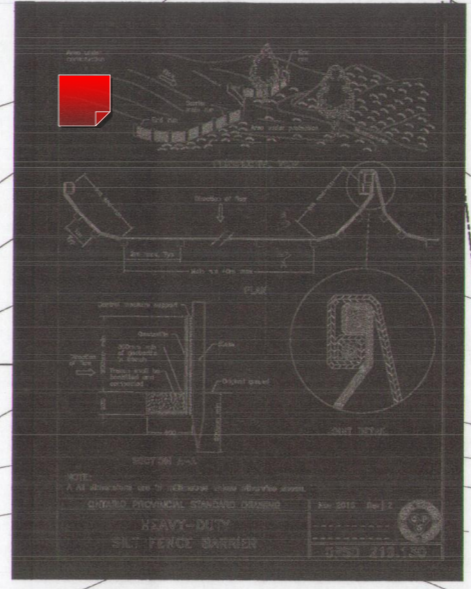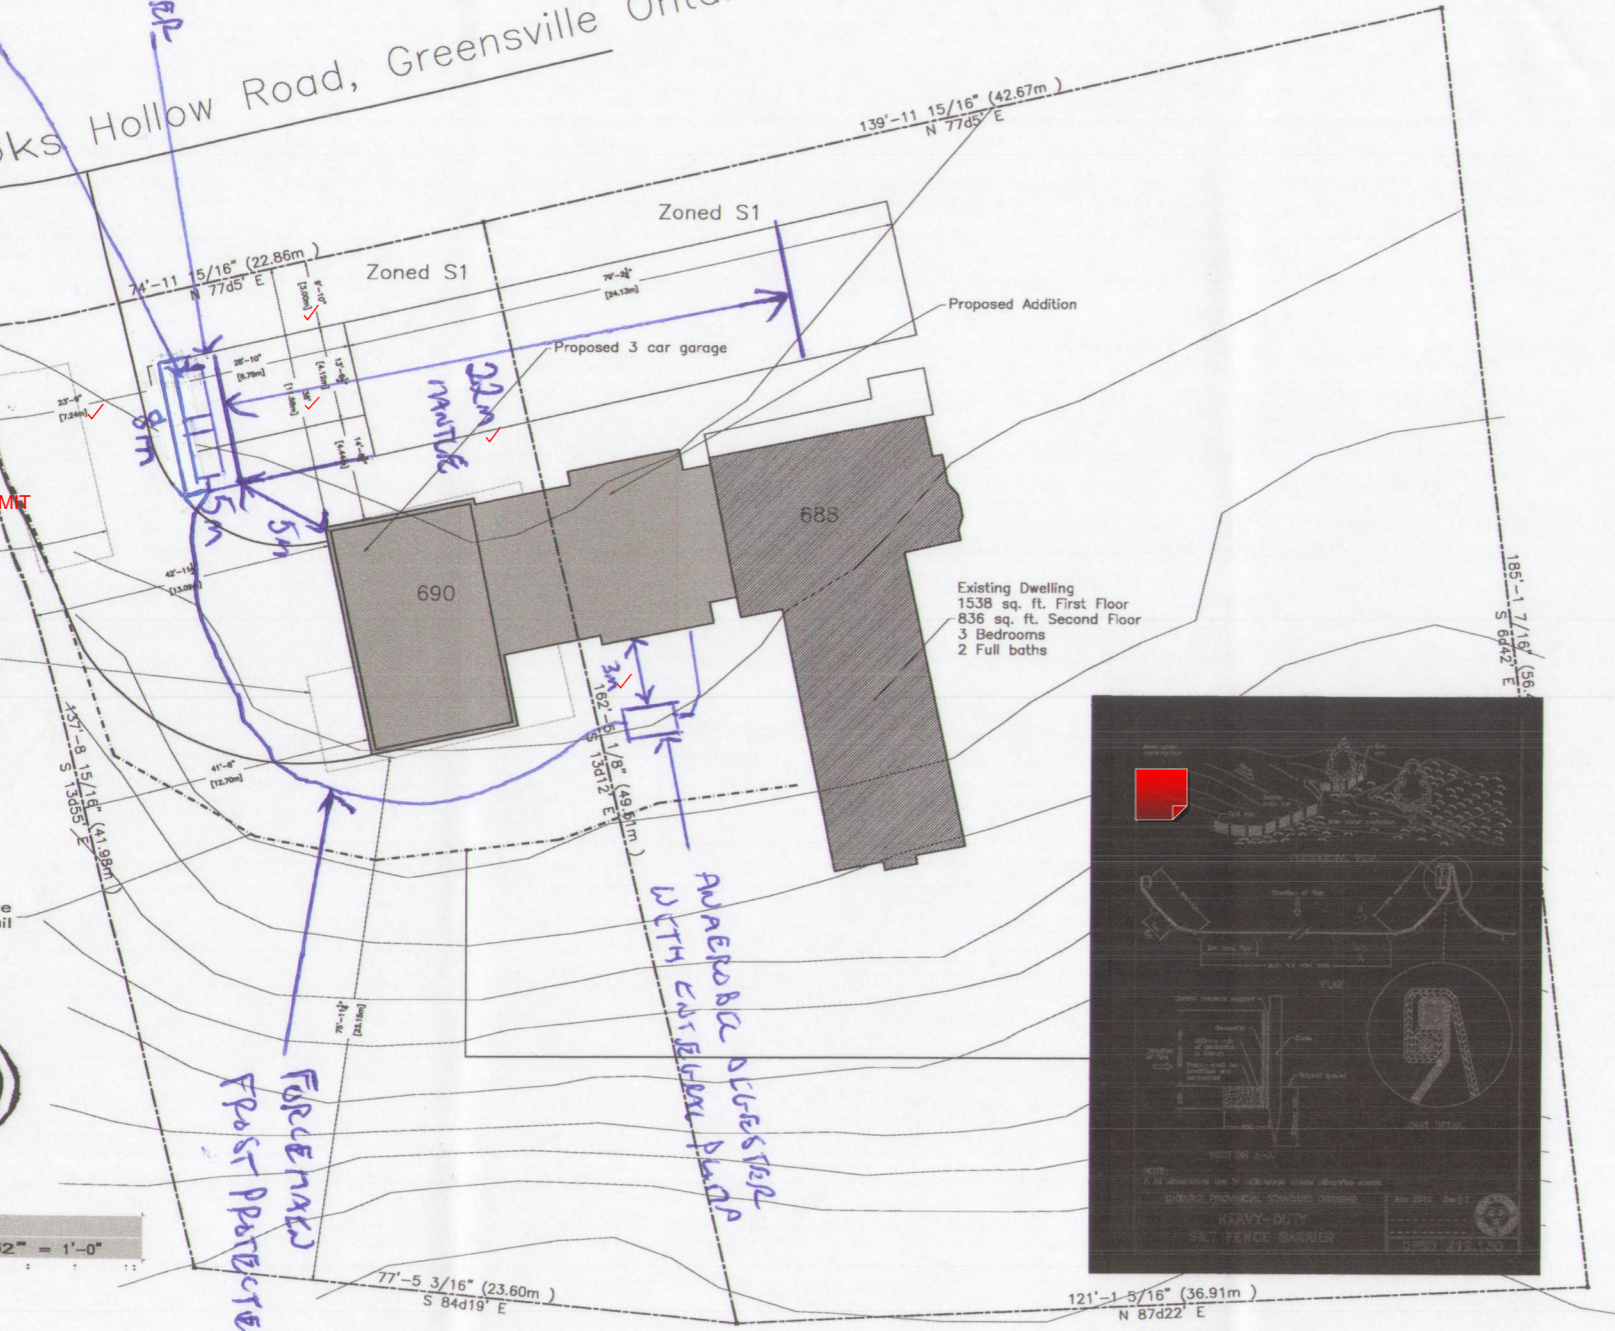

**VIRTUAL CREATIONS INC.** PROJECT NUMBER: **28844** CLIENT: **ERIC CANTON BCIN#25135**  
 (905) 481-1155 PROJECT ADDRESS: **Crooks Hollow Road, Dundas Ontario** CLASSIFICATION: **SMALL BUILDINGS**  
 ORIGINAL SIGNATURE: **WWW.VCINC.CA**  
IF VIRTUAL CREATIONS INC. THE BEST EFFORT HAS BEEN MADE TO RECORD EXISTING BUILDING STRUCTURES AND PROPOSED A COMPREHENSIVE SET OF CONSTRUCTION DRAWINGS. HOWEVER, THESE ARE ISSUED AT THE TIME OF RECORDING THAT ARE AVAILABLE OR ACCESSIBLE. WITH PROPER OCCUPATIONAL STANDARDS SUCH AS ROOF TRUSSES AND DIMENSIONAL FLOOR JOIST TO VERTICAL DIMENSIONS. VIRTUAL CREATIONS INC. TO ADVISE PRIOR TO AMBULATION. SETTING LOCATIONS OF EXISTING BUILDINGS FROM VERTICAL CREATIONS INC. OF ANY DIMENSIONS. DIMENSIONS OF SUBSTITUTIONS OR SUBSTITUTIONS OF DIMENSIONS OF DIMENSIONS OF DIMENSIONS. ALL DIMENSIONS AND DIMENSIONS ARE THE SOLE PROPERTY AND COPYRIGHT OF VIRTUAL CREATIONS INC. ANY REPRODUCTIONS MUST BE AUTHORIZED BY VIRTUAL CREATIONS INC. OR PURCHASED THROUGH VIRTUAL CREATIONS INC. DIRECTLY.

SP1-



**Reviewed for Ontario Building Code Compliance.**  
 Subject to Corrections Noted on Plans and Field Inspections.

Permit: 21 104287 000 00 SS  
 Date: 05/19/21  
 Name: Laurie Smith  
 Approved by: [Signature]

Draft A\_nov30-2017-8.ppt